


IF IT IS FOUND DESIRABLE TO CHANGE ANY TOLERANCE OR OTHER DETAIL SPECIFIED ON THIS DRAWING NOTIFY THE PURCHASER PROMPTLY.

MAXIMUM ALLOWABLE TOLERANCES HAVE BEEN DETERMINED AND DEVIATIONS WILL BE CAUSE FOR REJECTION. REMOVE ALL BURRS AND SHARP EDGES


**NOTICE TO PERSONS RECEIVING THIS DRAWING**

THE TECHNICAL MATERIEL CORPORATION claims proprietary right in the material disclosed hereon. This drawing is issued in confidence for engineering information only and may not be reproduced or used to manufacture anything shown hereon without permission from THE TECHNICAL MATERIEL CORPORATION to the user. This drawing is loaned for mutual assistance and is subject to recall at any time.

Property of:  
THE TECHNICAL MATERIEL CORPORATION  
MAMARONECK, NEW YORK

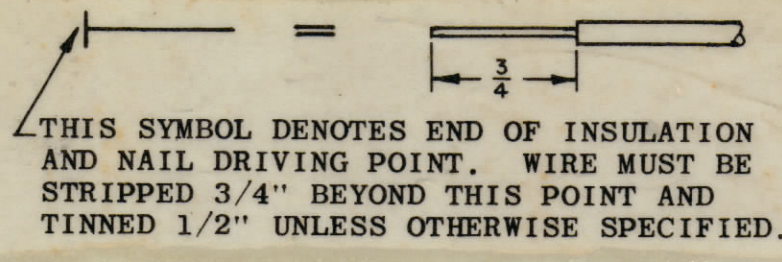


WIRES SHOULD BE PLACED IN CABLE IN NUMERICAL SEQUENCE AS THEY APPEAR IN ITEM COLUMN. SPACE LACING APPROXIMATELY 3/4" APART.

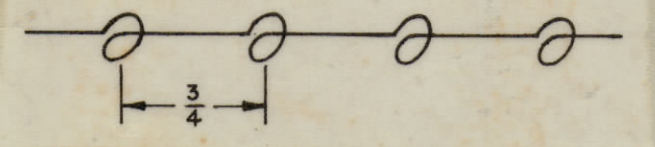

LENGTH FOR R.F. CABLES

PART NUMBER	ITEM	SIZE	COLOR	LENGTH
MWC22(7)U92	1	22	WH.-RED	22
	U3	22	ORANGE	21 1/4
	U6	22	BLUE	7 1/4
	U1	22	BROWN	7 3/4
	<del>U2</del>	<del>22</del>	<del>DELETED</del>	<del>7</del>
	U5	22	GREEN	6 1/2
	U0	22	BLACK	5 3/4
	U94	22	WH.-YEL.	15
	U94	22	WH.-YEL.	24 1/4
	U93	22	WH.-OR.	15 3/4
	U6	22	BLUE	15 3/4
MWC22(7)U8	12	22	GREY	7
CD-101-1-MW	13	#	BLACK	#

CA-123 B

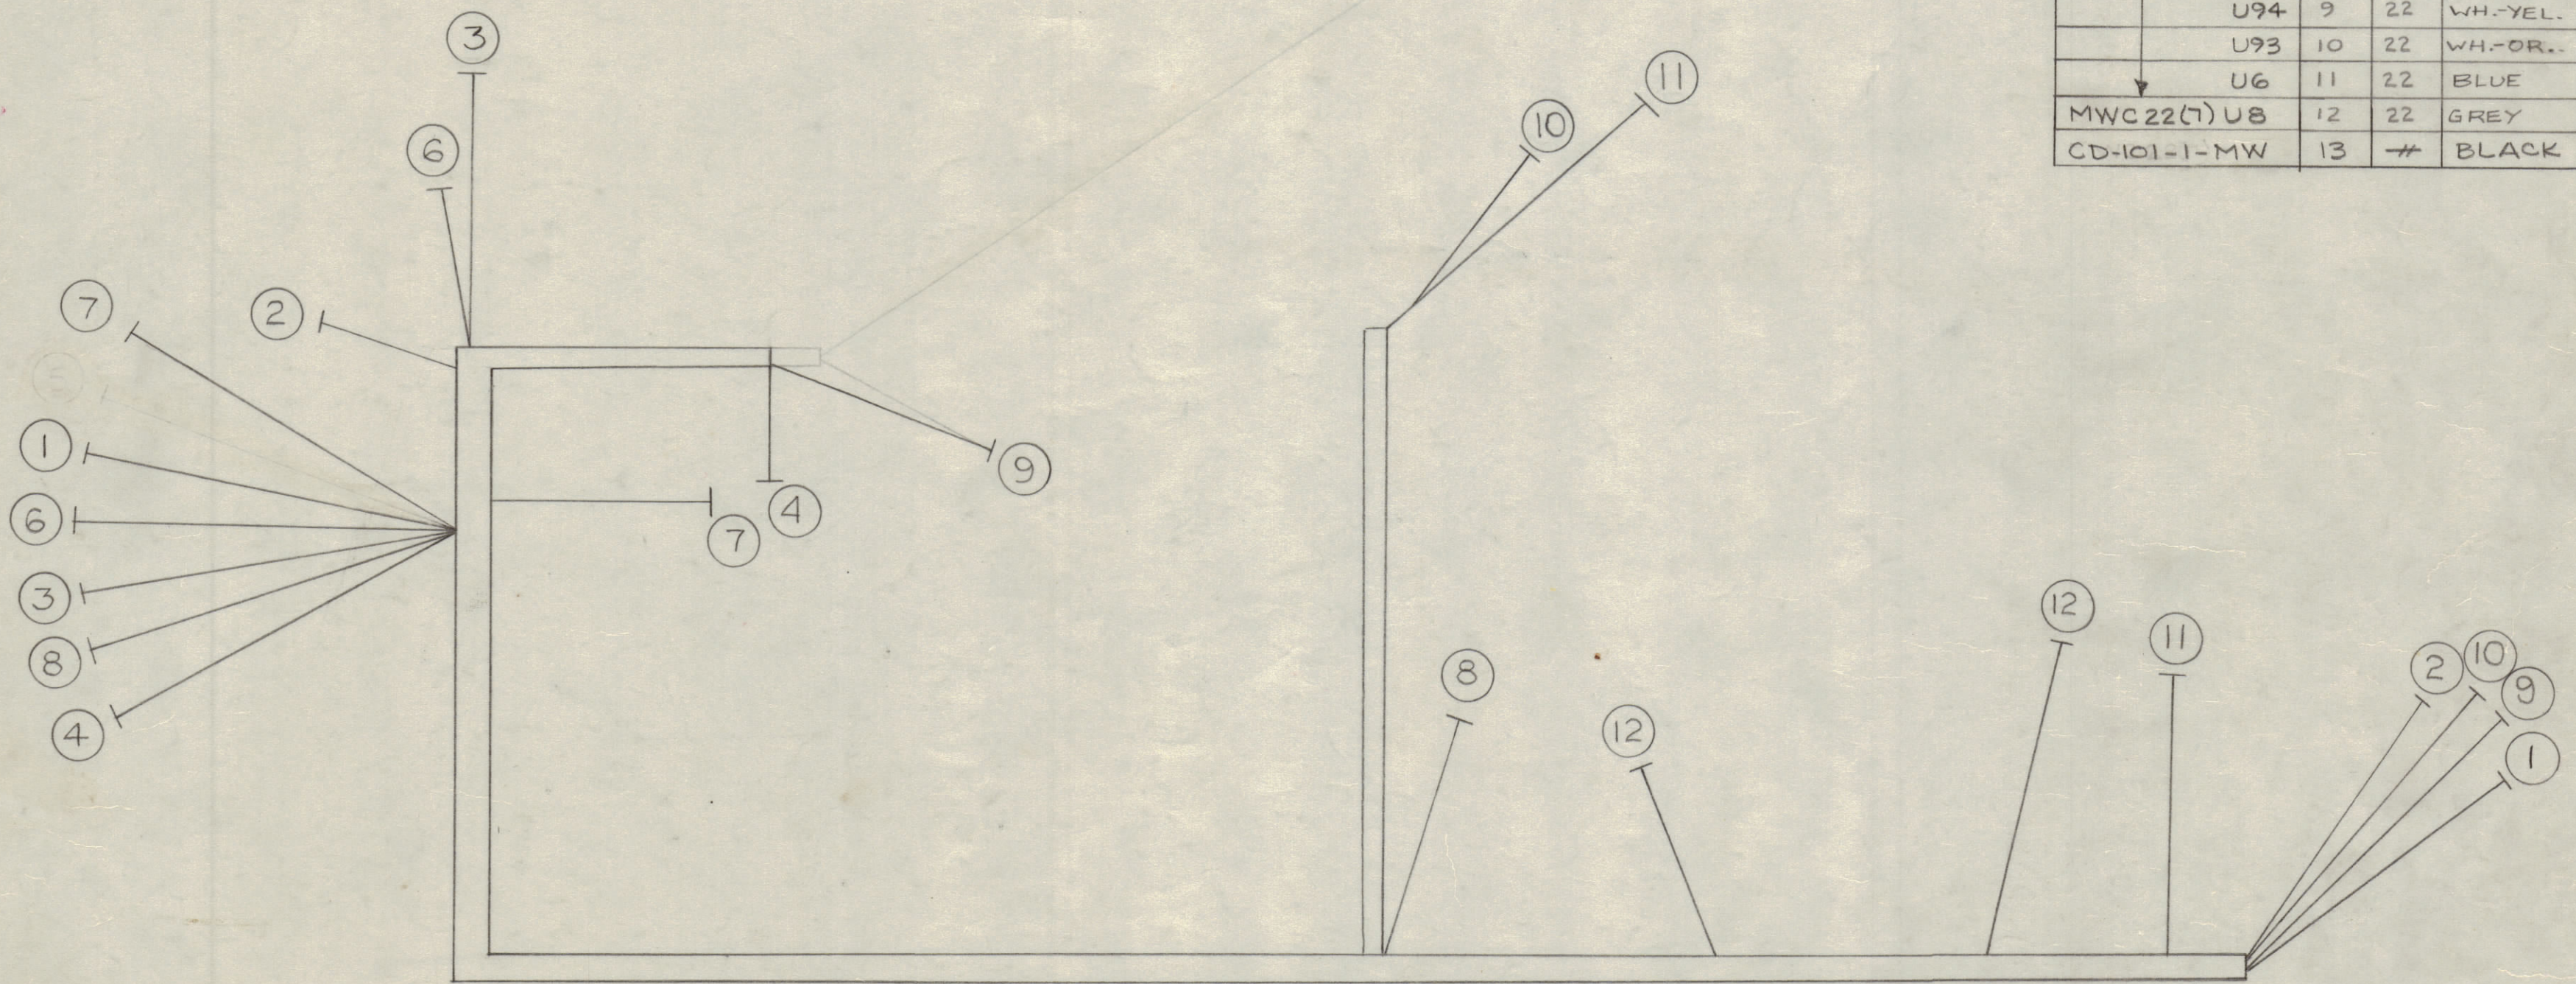

BOTTOM VIEW OF CABLE

B	2	TMC PART NO'S ADDED	1-18-	957				
	1	CHART (1) TO (4) (6) TO (12)	63					
A	1	ITEM (13) ADDED	2-18-52	1				
		ITEM 5 DELETED						
ISSUE	ITEM	CHANGED FROM	DATE	CN. NO.	DRAFTS	CHECKER	ENG. APP.	
TOLERANCES		SCALE:						
ALL OTHERS	DEC. DIM. ± FRAC. DIM. ± ANGULAR DIM. ±	DRILL, PUNCH, COMMERCIAL STOCK SIZES AND MANUFACTURERS TOLERANCES ARE NOT INCLUDED.						

1	VOX-3,4,5			2-26-62
1	VOX-2			6-7-55
1	VOX-2	101	A-617	9-18-52
PER UNIT	MODEL	PROJECT NO.	ASS'Y. NO.	DATE
USED ON				

REQ. ITEM	PART NO.	DESCRIPTION	SYMBOL
#		THE TECHNICAL MATERIEL CORP. MAMARONECK, NEW YORK	
#		R.F. CHASSIS CABLE	
MATERIAL	WEIGHT PER PC.		
TYPE & TEMPER			
HEAT TREAT. SPEC.			
FINISH & SPEC. NO.			

DRAWN: *L. G. Lab...*  
 ELEC. DES. APP.: *[Signature]*  
 MECH. DES. APP.: *[Signature]*  
 CHECKED: *[Signature]*  
 FINAL APPROVAL: *[Signature]*

CA-123 B